




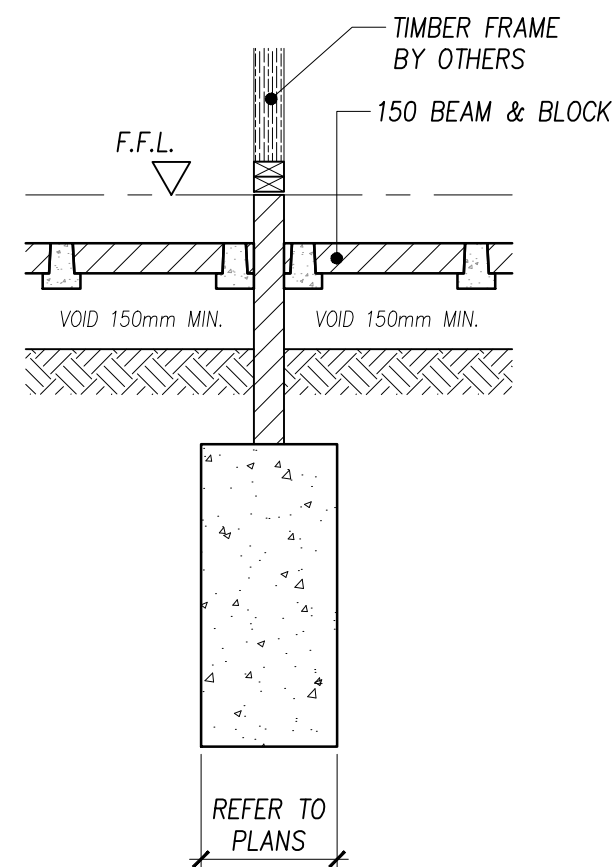


SECTION Y-Y
SCALE 1:25

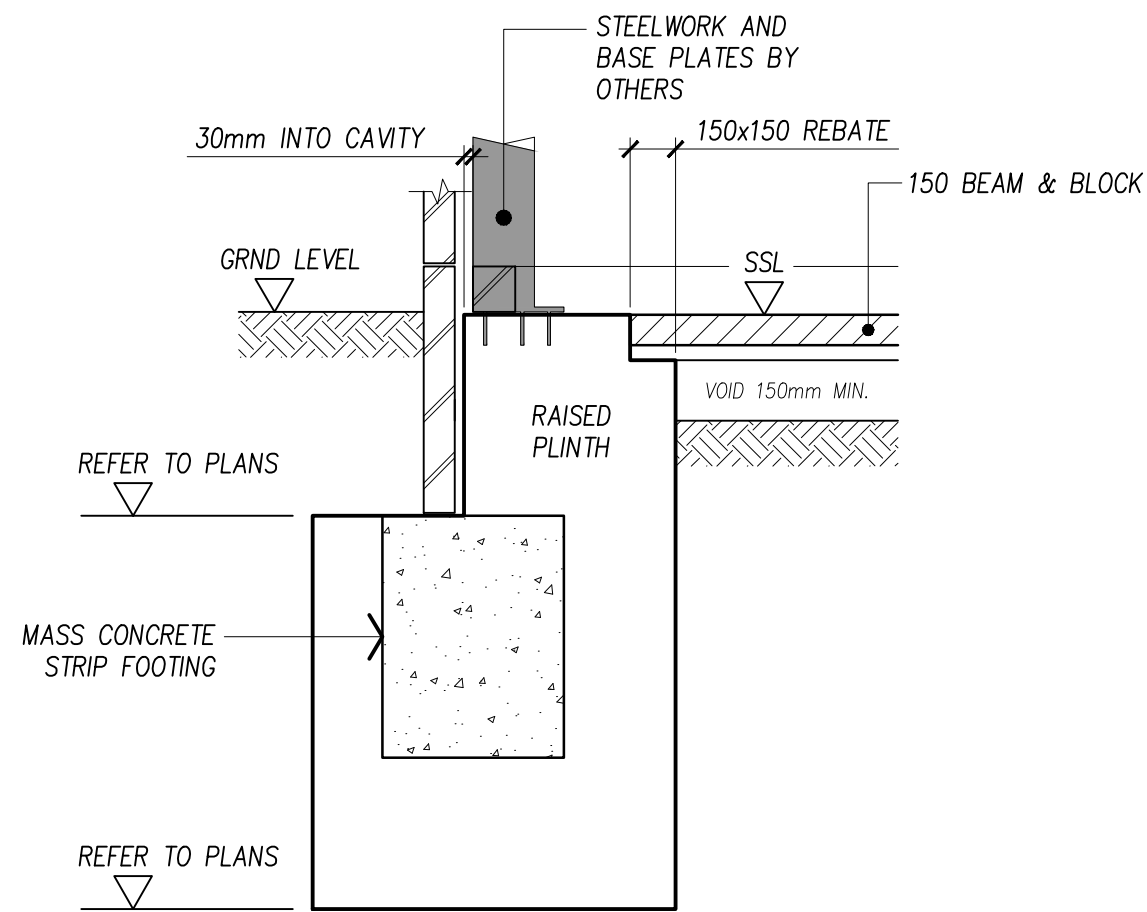

SECTION Z-Z
SCALE 1:25

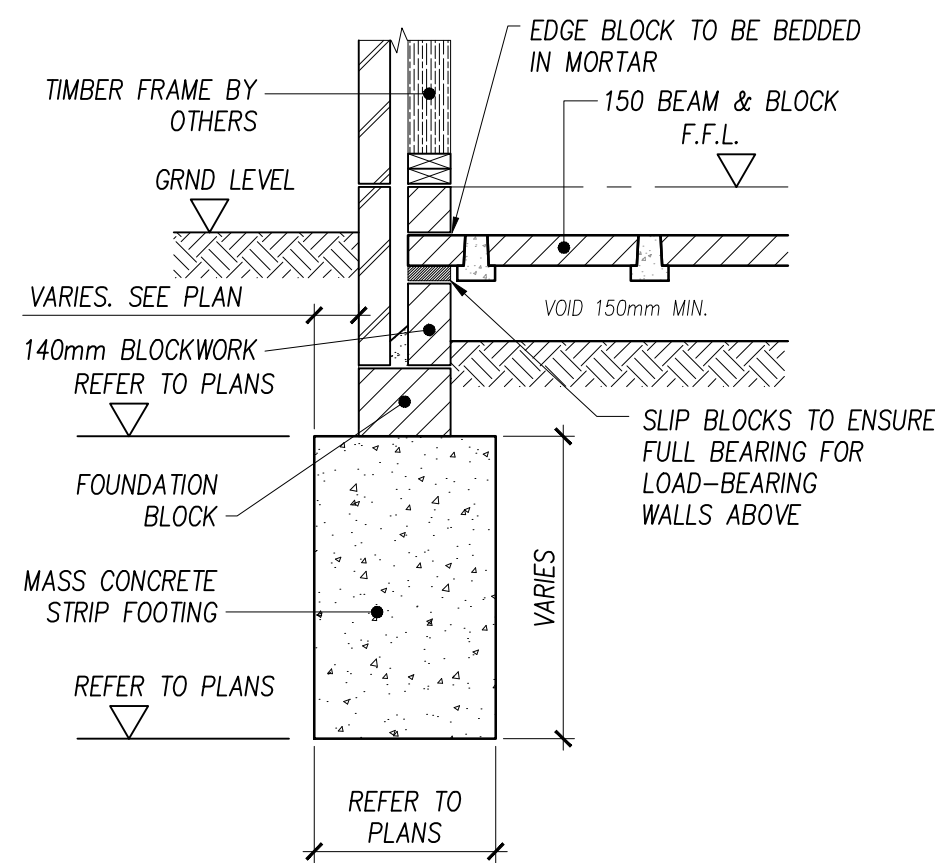

TYPICAL PERIMETER FOUNDATION SECTION
SCALE 1:25

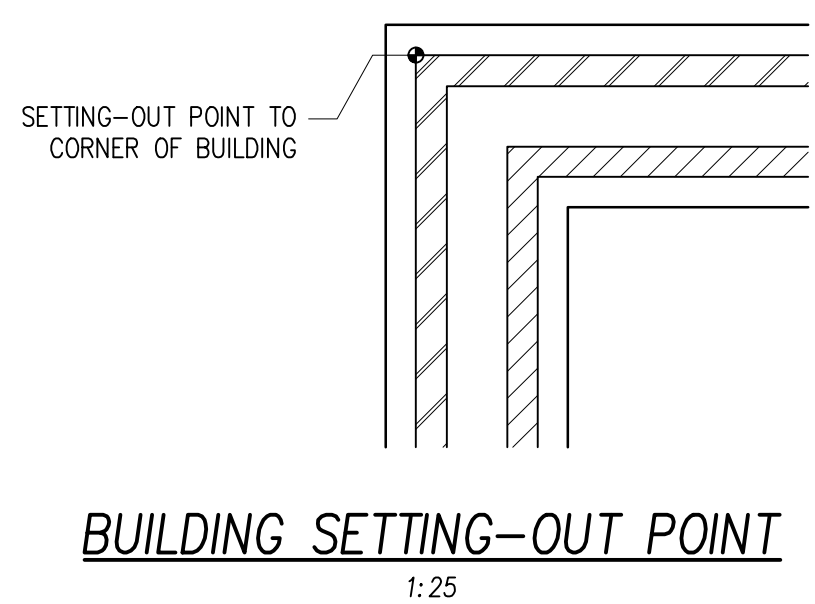


BUILDING SETTING-OUT POINT
1:25

SHADED AREAS DENOTE RAISED
PLINTHS ABOVE PAD FOOTINGS
STEEL COLUMNS (BY OTHERS) TO
BE FIXED TO TOP OF PLINTH

CONTINUED ON DRAWING No GDC-00-00-DR-S-3044

SHADED AREAS DENOTE RAISED
PLINTHS ABOVE PAD FOOTINGS
STEEL COLUMNS (BY OTHERS) TO
BE FIXED TO TOP OF PLINTH

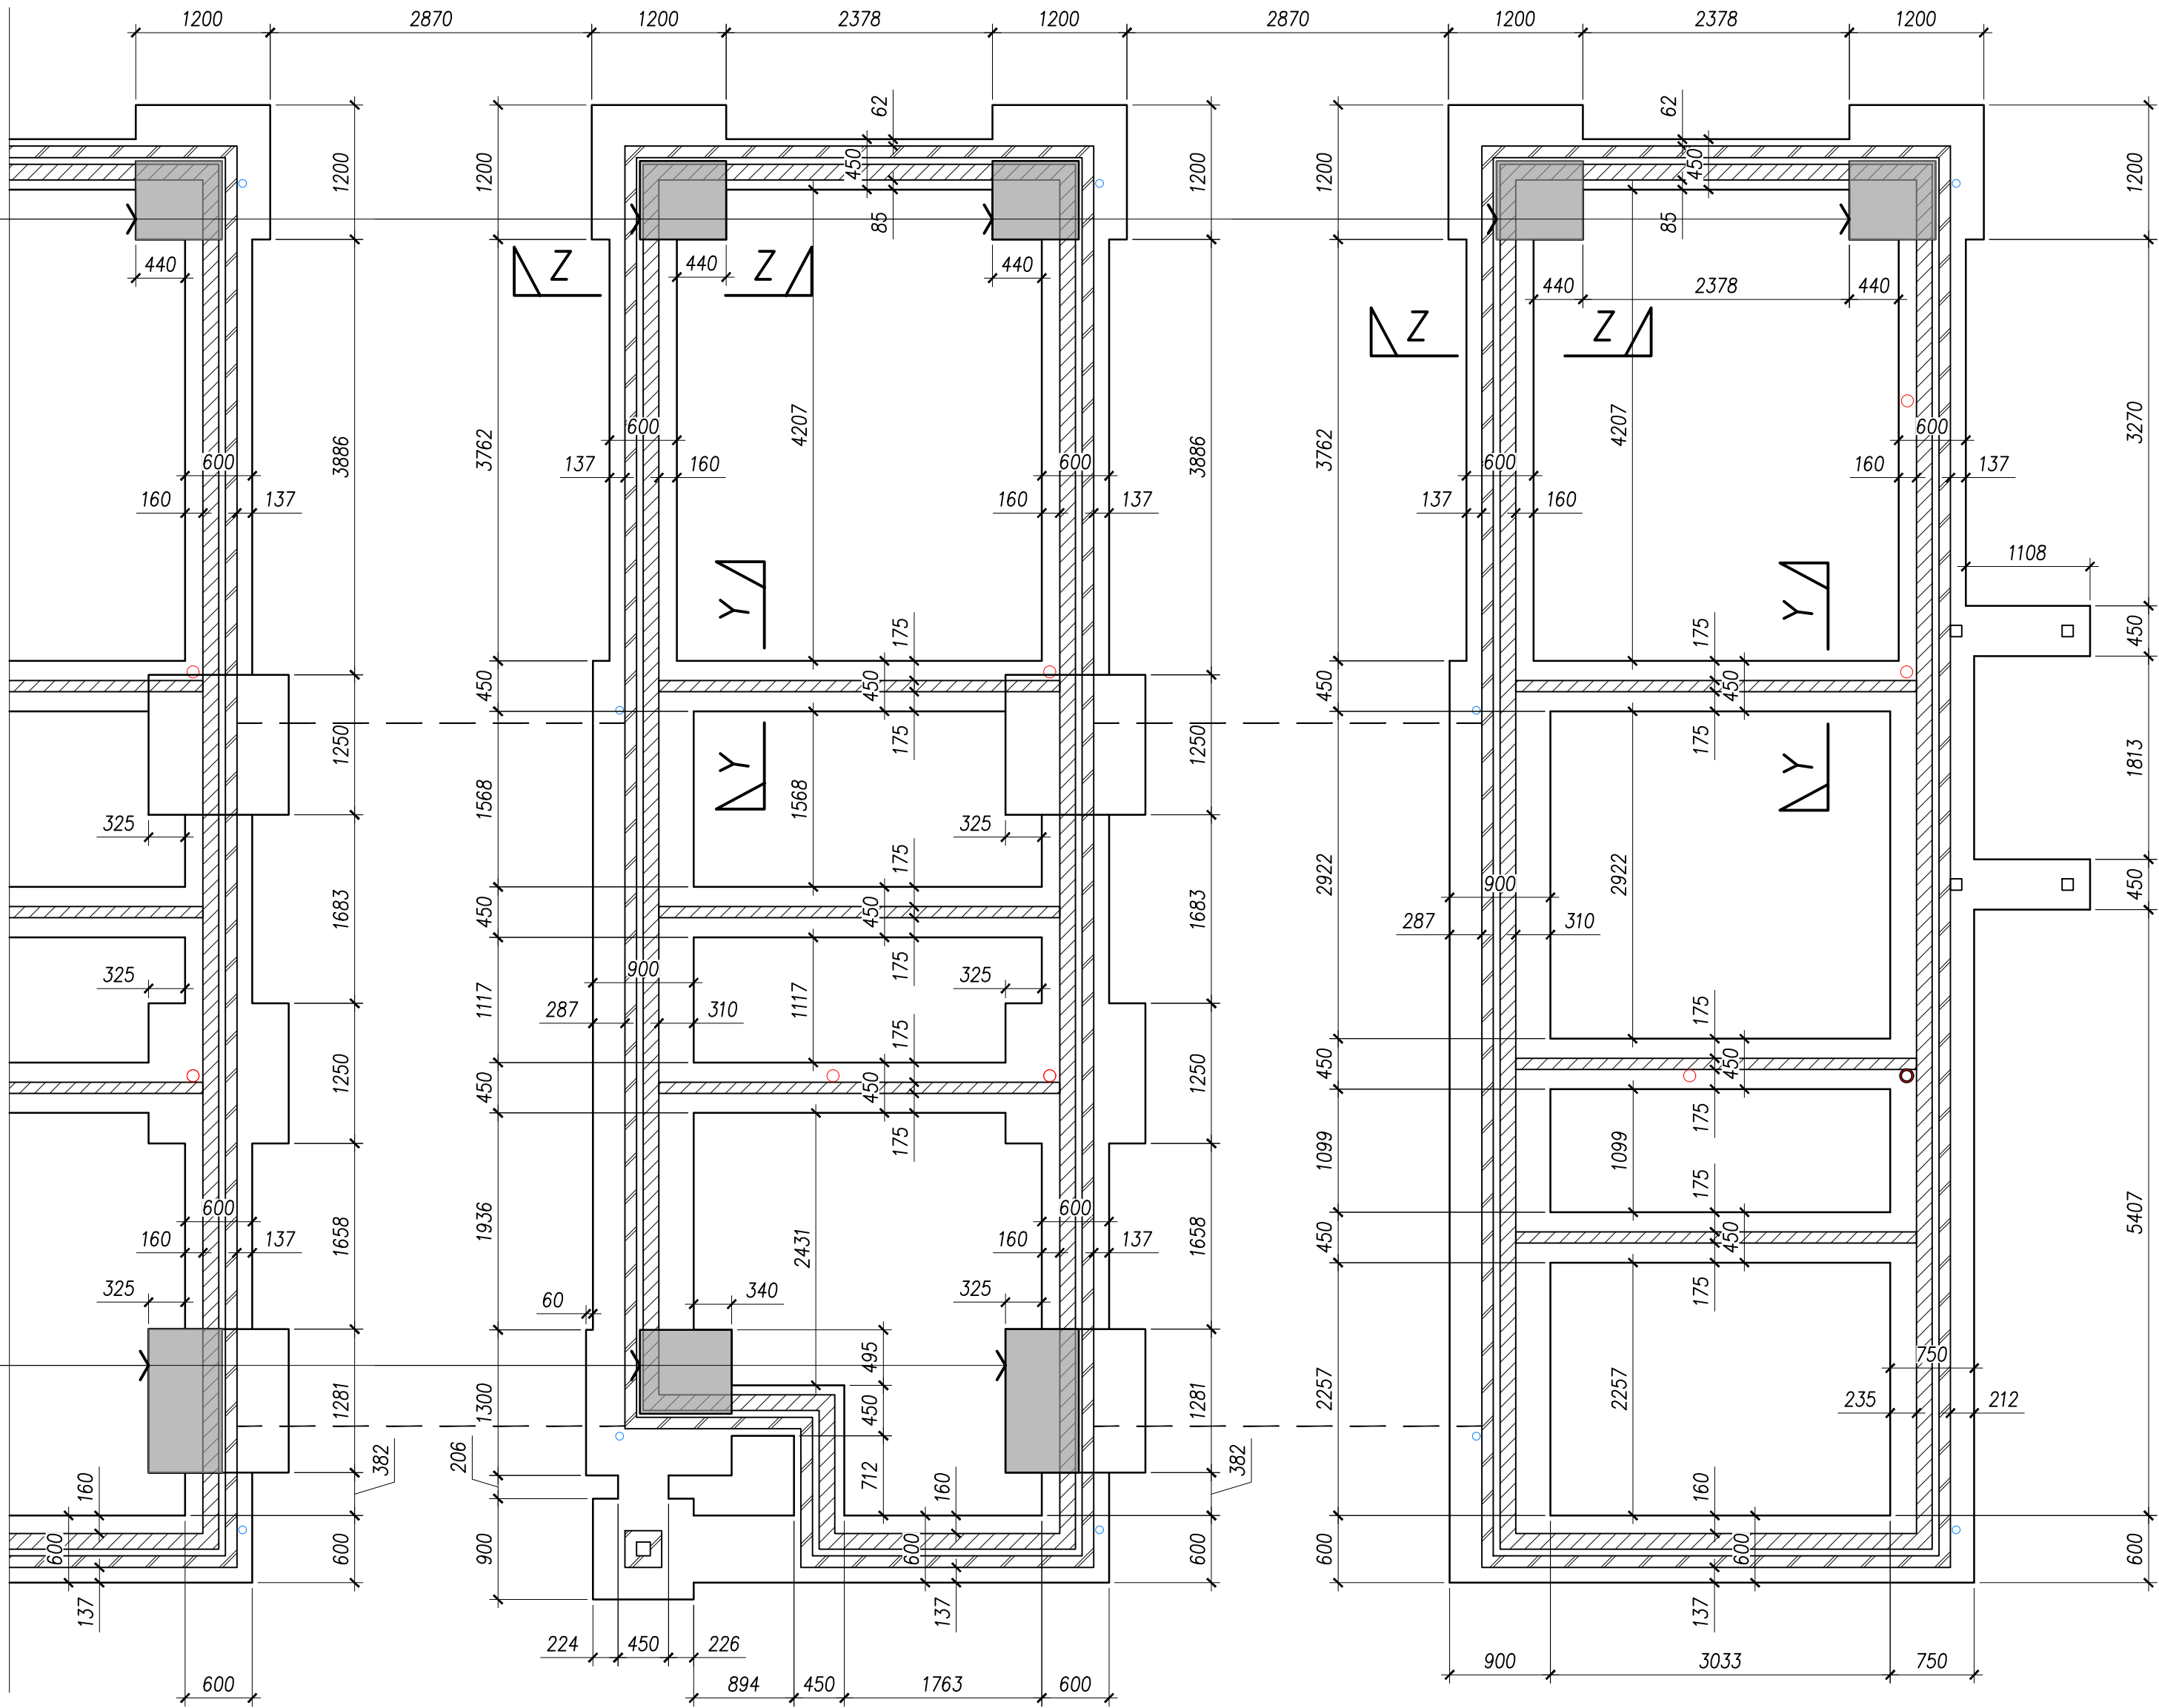

PLOT 104

PLOT 103

PLOT 102

HT 4.4a & 4.4b TERRACE FOUNDATION PLAN
SCALE 1:50

FOUNDATION AND SLAB LEVELS			
PLOT NUMBER	FFL	TOC	SOFFIT LEVEL
102	20.525	19.475	18.770
103	20.525	19.475	18.270
104	20.375	19.475	17.770
105	20.225	19.400	17.070
106	20.225	19.175	16.770

NOTES

- THIS DRAWING TO BE READ IN CONJUNCTION WITH ALL RELEVANT DRAWINGS AND SPECIFICATION
- STRIP AND PAD FOUNDATIONS TO USE GEN 2 CONCRETE
- DPC TO ARCHITECT'S DETAILS
- INSULATION AND FINISHES TO ARCHITECT'S DETAILS

LEGEND

- BLOCKWORK DENSITY 1500kg/m³ MIN.
COMPRESSIVE STRENGTH 7.3N/mm²
MORTAR GRADE M6
- BRICKWORK TO ARCHITECT'S DETAILS
- 150mm BEAM & BLOCK FLOOR

NOTE:
WHERE A 100mm WIDE INTERNAL WALL SUPPORTS BEAM & BLOCK FLOORS ON BOTH SIDES, THE BEAM & BLOCK FLOORS ARE TO BE STAGGERED TO ENSURE THAT EACH BEAM GAINS FULL BEARING ONTO THE WALL

P02	BOC LEVELS TO PLOTS 105 & 106 UPDATED TO AS-BUILT LEVELS	ADP	JFK	08.07 2025
P01	ISSUED FOR APPROVAL	SEH	JFK	17.05 2024
Rev.	Description	By	Chkd.	Date

PRELIMINARY

G.D.C.
Partnership
Consulting Engineers

THIRD FLOOR
29 LONDON ROAD
BROMLEY
KENT, BR1 1DG (UK)
Tel: +44(0)20 8460 2160
Fax: +44(0)20 8313 3122
www.gdcpartnership.co.uk



Project
NETHERHALL GARDENS

Title
HT 4.4a & 4.4b TERRACE
FOUNDATIONS SHEET 2

Drawn	SEH	Chkd.	WTF	Appd.	DSM
Scale	1:50 @A1	Drg. No.			Rev.
Project No.	9013	GDC-00-00-DR-S-3045			P02