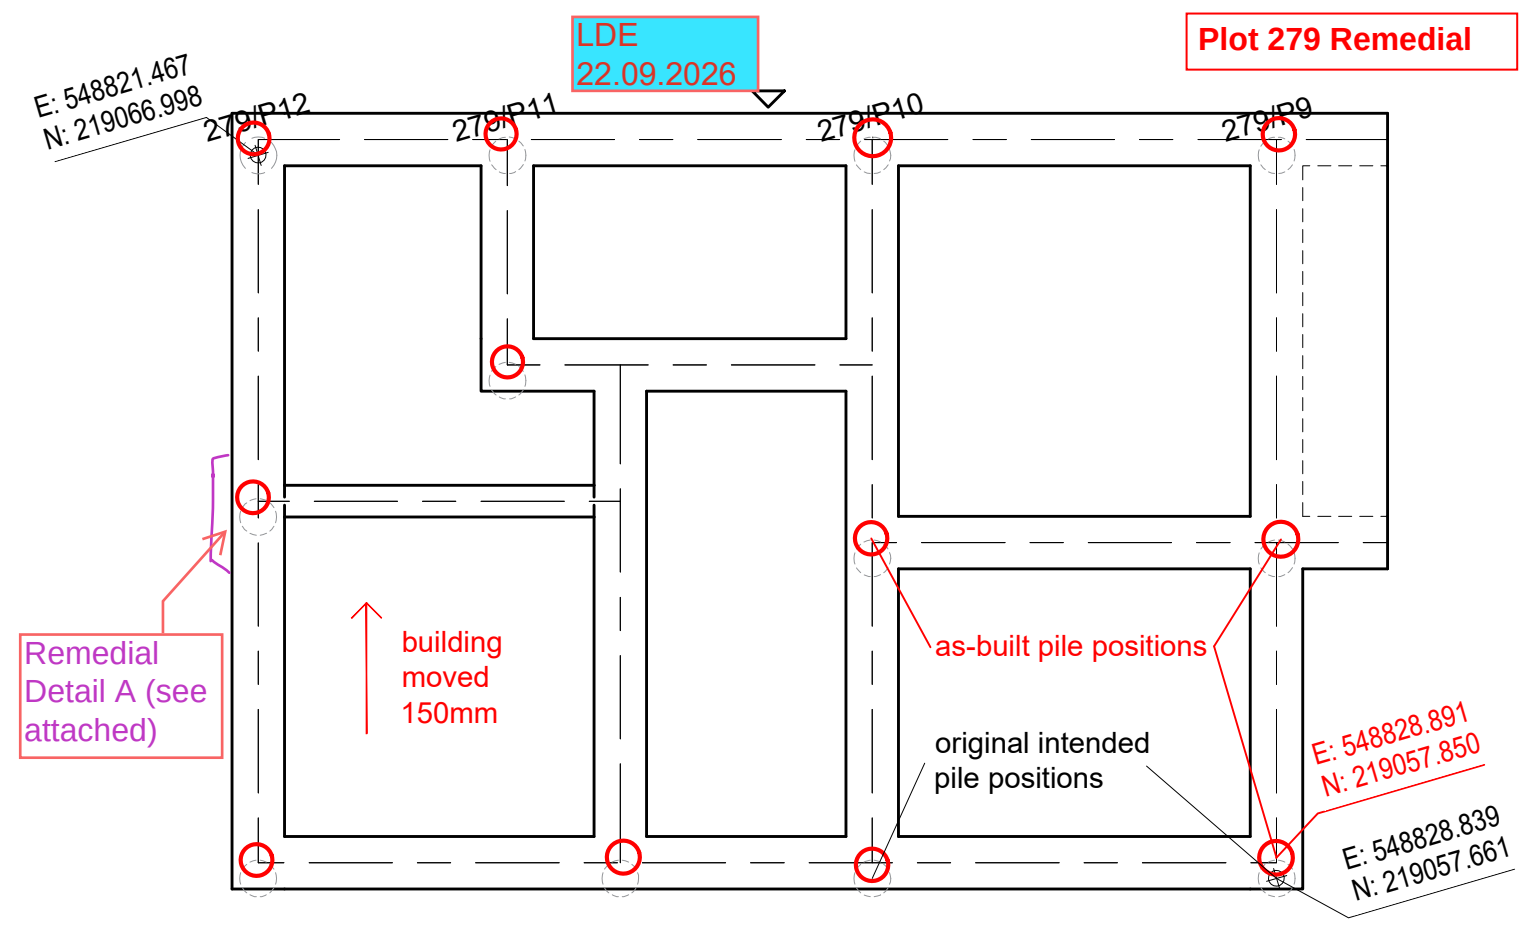

LDE
22.09.2026
Plot 279 Remedial
E: 548821.467
N: 219066.998
279/P12
279/P11
279/P10
279/P9
Remedial
Detail A (see
attached)
building
moved
150mm
as-built pile positions
original intended
pile positions
E: 548828.891
N: 219057.850
E: 548828.839
N: 219057.661