Notes:
Electromagnetic and/or Ground Penetrating Radar techniques have been used to locate/map underground utilities and features on this drawing. Cadmap Ltd has made every endeavour to make sure that the information contained within this drawing is accurate and of the highest quality. Cadmap Ltd has used any record drawings provided by the client or by the Statutory Utility Providers, at the client's request, at the time of the survey. Any information taken from these drawings (e.g. pipe sizes and position) is not guaranteed. Historic record information is often incomplete and inaccurate and cannot be relied upon. Cadmap Ltd is not liable for any topographical survey that has not been undertaken by us. Any inaccuracies relating to topographical plans/development plans/Ordnance Survey data that we have no control over is the liability of the customer. Where quoted, depth information of underground services/features is stated. Depths are generally within +/10% accurate, but cannot be guaranteed. Any depths shown on drains are usually to invert (base of drainage channel) unless otherwise stated. At Cadmap Ltd we use skilled staff and modern, calibrated equipment to perform our surveys. However, the completeness of any underground survey cannot be 100% guaranteed and the results from these types of surveys are not infallible. If the location or depth of services/features is of particular importance to a project then it is strongly recommended that discussions are held with Cadmap Ltd regarding any possible limitations or anomalies. It is also strongly advised that trial excavations should be undertaken to confirm survey results. We cannot be held responsible for any inaccuracies beyond those that could be reasonably expected by a competent company.

ABBREVIATIONS (Land & Utilities)

AR	ASSUMED ROUTE	KD	KERB DUTLET	SIL	SIGNAL LOST
AV	AIR VALVE	Lby	LIFEBOUY	SP	SIGN POST
BB	BELISHA BEACON	Lck	LOCK GATE	SPk	SHEET PILING
BD	BACKDROP	Ldr	LADDER	Spr	SPRING
BdL	BED LEVEL	LH	LAMP HOLE	SPs	SAMPLING POINT
BH	BOREHOLE	LP	LAMP POST	ST	STOP TAP
BHch	BASEMENT HATCH COVER	LV	LOW VOLTAGE	Stl	STILE
Bin	LITTER / GRIT SALT BIN	MgP	MOORING POST	Stl	STRUCTURE TOP LEVEL
BL	BASEMENT LIGHT	mH	METERS HIGH	Stp	STUMP (TREE)
Bol	BOLLARD	Mncy	MACHINERY	StP	STAND PIPE
BP	BOUNDARY POST	MH	MANHOLE	StPo	STAY POST
BS	BUS STOP	Mkr	MARKER POST	StW	STAY WIRE
BTIC	BRITISH TELECOM CHAMBER	MkrE	MARKER POST (ELECTRIC)	SV	STOP VALVE
CatL	CATENARY LEVEL	MkrG	MARKER POST (GAS)	SVP	SOIL VENT PIPE
CATV	CABLE TV COVER	MkrR	MARKER POST (RAILWAY)	TBM	TEMPORARY BENCH MARK
CB	CONTROL BOX	MkrT	MARKER POST (TELECOM)	TCB	TELEPHONE CALL BOX
CBlt	CONVEYOR BELT	MkrV	MARKER POST (WATER)	TEL	TELECOM CHAMBER COVER
CC	COAL CHUTE	MP	MILE POST	TFR	TAKEN FROM RECORDS
CGrd	CATTLE GRID	MS	MILE STONE	Thl	THRESHOLD LEVEL
CHL	CHANNEL LEVEL	NL	NOT LOCATED	TL	TRAFFIC LIGHT
Chy	CHIMNEY	NP	NAME PLATE	TP	TELEGRAPH POLE
CI	CAST IRON	OSA	OUTSIDE SURVEY AREA	Tpt	TRIAL PIT
CL	COVER LEVEL	OSBM	O.S BENCH MARK	Tr	TROUGH
CO	CONCRETE	OGP	OVERGROUND PIPE	UTF	UNABLE TO FIND
CP	CABLE PIT	OHCu	O/H CABLE (UNIDENTIFIED	UTGA	UNABLE TO GAIN ACCESS
CpL	COPING LEVEL	OHE	OVERHEAD CABLE (ELECTRIC	UTL	UNABLE TO LIFT
Cpsn	CAPSTAN	OHG	OVERHEAD GANTRY	UTR	UNABLE TO ROD
Cpst	CAMERA POST	OHP	OVERHEAD PIPE	UTS	UNABLE TO SURVEY
CR	CABLE RISER	OHT	OVERHEAD CABLE (TELECOM	UTT	UNABLE TO TRACE
CrL	CROWN LEVEL	OP	OUTLET PIPE	VC	VITREOUS CLAY
CulP	CULVERT PIPE	P	POST	VP	VENT PIPE
CWM	CABLE WINDING MACHINERY	Pb	PARK BENCH	VR	VAPOUR RECOVERY
d	DEPTH	PB	POST BOX	VS	VENTILATION SHAFT
Dia.	DIAMETER	PCsg	PEDESTRIAN CROSSING	VW	VALVE / SLUICE WHEEL
DS	DIRECTION SIGN	PE	POLYETHALINE	WB	WEIGHBRIDGE
EIC	ELECTRIC INSPECTION COV	PF	PITCH FIBER	WL	WATER LEVEL
EoC	EDGE OF CANOPY	Pl	PILE	WM	WATER METER
EOR	END OF RECORDS	Pm	MOVEMENT DETECTOR	WO	WASH OUT VALVE
EOT	END OF TRACE	Pmd	PLANT MOTOR DRIVE	Wr	WEIR
EP	ELECTRICITY POLE	PP	PETROL / DIESEL PUMP	WrL	WEIR LEVEL
ER	EARTH ROD	PR	PIPE RISER	WrPl	WEIR PLATE (TOP)
EShwr	EMERGENCY SHOWER	Psk	PENSTOCK	WWP	WASTE WATER PIPE
ESP	ELECTRICITY SUPPLY POINT	PU	PUMP		FENCE TYPES)
Esw	ELECTRICAL SWITCH	PV	PIPE (VERTICAL)		
FB	FOOTBRIDGE	PVC	POLYVINYL CHLORIDE	AMF	ARMCO
FH	FIRE HYDRANT	Pyl	PYLON	BWF	BARBED WIRE
FL	FLOOR LEVEL	Pz	PIEZOMETER	CBF	CLOSE BOARDED
FS	FLAG STAFF / POLE	RE	RODDING EYE	CIF	CORRUGATED IRON
G	GULLY	RG	RAIN GAUGE	CLF	CHAIN LINK
G=	GIRTH	RMP	RESERVOIR MONITORING PNT	CPF	CHESTNUT PALING
GIP	GAS INLET PIPE	RP	REFLECTOR POST	IRF	IRON RAILING
GP	GUIDE POST	RS	ROAD SIGN	IWF	INTERWOVEN
GPR	TRACED BY G.P.R	RSP	RAILWAY SIGNAL POST	PCF	POST & CHAIN
Grl	GRILLE	RWP	RAIN WATER PIPE	PIF	POST & IRON RAIL
GV	GAS VALVE	S	SPREAD	PRF	POST & RAIL
Hgt	HEIGHT	SA	SURVEY ABANDONED	PWF	POST & WIRE
HrL	HANDRAIL	SB	SIGN BOARD	SPF	STEEL PALLISADE
HV	HIGH VOLTAGE	Shlt	SHELTER (BUS / TRAM)	WMF	WIRE MESH
IC	INSPECTION CHAMBER	SI	SPUN IRON		
IL	INVERT LEVEL	SL	SOFFIT LEVEL		
IP	INLET PIPE	StL	SILT LEVEL (TOP)		
JN	JUNCTION	SMP	SETTLEMENT MONITORING PNT		

KEY

TV	CCTV / CABLE TELEVISION
450	COMBINED DRAINAGE
CDM	COMMUNICATIONS CABLE
A	COMPRESSED AIR
	DUCTING
E	EARTH CABLE
	ELECTRIC CABLE
EOT	END OF TRACE
150	FOUL DRAINAGE
F	FUEL PIPE
	GAS PIPE
G	GAUGE LINE
H	HEATING
O	OFFSET FILL PIPE
	PUMPING MAIN
	RADAR AREA ANOMALY
R	RADAR UTILITY TRACE
300	SURFACE DRAINAGE
	SURVEY BOUNDARY
T	TELECOM CABLE
TL	TRAFFIC LIGHTS
U	UNIDENTIFIED
VR	VAPOUR RECOVERY
V	VENT PIPE
	WATER PIPE

North:

Grid: By Others

Levelling: By Others

Drawing Title:
Underground Utility Survey

Site Address:
Egley Road
Woking

Client:
Cala Homes

Surveyor	AP	Drawn By	CP	Verified By	SC	Date	27.03.23

CM No: CMU/23204 Rev:

Scale: 1:200m @ A0 Date: April 2023

Cadmap
Cadmap Ltd
Unit 131 Dunsfold Park
Cranleigh
Surrey, GU6 8TB
T: 01483 429385
E: info@cadmap.co.uk
W: www.cadmap.co.uk

SMAS worksafe consultant www.smaslld.com
SSIP
CHAS Accredited Contractor www.chas.gov.uk
THE SURVEY ASSOCIATION
Constructionline

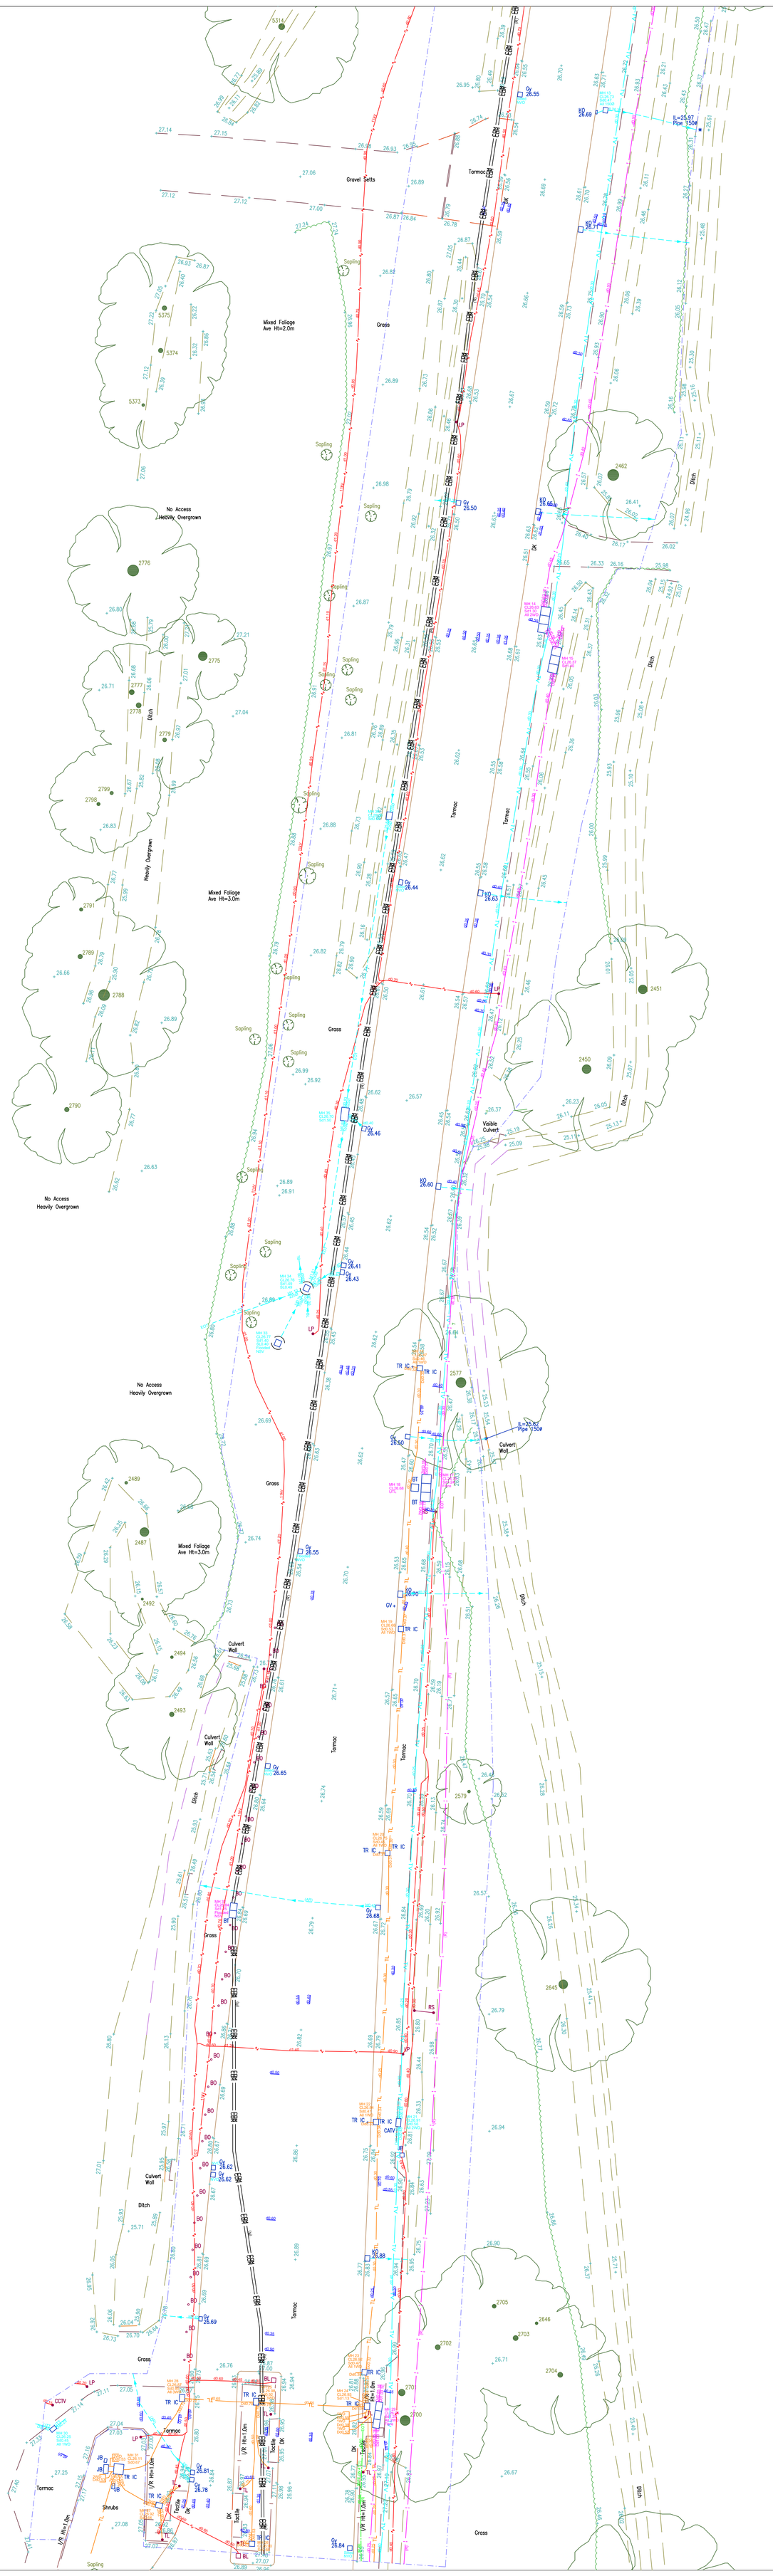

Notes:
Electromagnetic and/or Ground Penetrating Radar techniques have been used to locate/map underground utilities and features on this drawing. Cadmap Ltd has made every endeavour to make sure that the information contained within this drawing is accurate and of the highest quality. Cadmap Ltd has used any record drawings provided by the client or by the Statutory Utility Providers, at the client's request, at the time of the survey. Any information taken from these drawings (e.g. pipe sizes and position) is not guaranteed. Historic record information is often incomplete and inaccurate and cannot be relied upon. Cadmap Ltd is not liable for any topographical survey that has not been undertaken by us. Any inaccuracies relating to topographical plans/development plans/Ordnance Survey data that we have no control over is the liability of the customer. Where quoted, depth information of underground services/features is stated. Depths are generally within +/10% accurate, but cannot be guaranteed. Any depths shown on drains are usually to invert (base of drainage channel) unless otherwise stated. At Cadmap Ltd we use skilled staff and modern, calibrated equipment to perform our surveys. However, the completeness of any underground survey cannot be 100% guaranteed and the results from these types of surveys are not infallible. If the location or depth of services/features is of particular importance to a project then it is strongly recommended that discussions are held with Cadmap Ltd regarding any possible limitations or anomalies. It is also strongly advised that trial excavations should be undertaken to confirm survey results. We cannot be held responsible for any inaccuracies beyond those that could be reasonably expected by a competent company.

ABBREVIATIONS (Land & Utilities)

AR	ASSUMED ROUTE	KO	KERB OUTLET	SiL	SIGNAL LOST
AV	AIR VALVE	Lby	LIFEBOUY	SP	SIGN POST
BB	BELISHA BEACON	Lck	LOCK GATE	SPil	SHEET PILING
BD	BACKDROP	Ldr	LADDER	Spr	SPRING
BdL	BED LEVEL	LH	LAMP HOLE	SPt	SAMPLING POINT
BH	BOREHOLE	LP	LAMP POST	ST	STOP TAP
BHch	BASEMENT HATCH COVER	LV	LOW VOLTAGE	Stl	STILE
Bin	LITTER / GRIT SALT BIN	MoP	MOORING POST	StL	STRUCTURE TOP LEVEL
BL	BASEMENT LIGHT	mH	METERS HIGH	Stp	STUMP (TREE)
Bol	BOLLARD	Mncy	MACHINERY	StP	STAND PIPE
BP	BOUNDARY POST	MH	MANHOLE	StPo	STAY POST
BS	BUS STOP	Mkr	MARKER POST	StW	STAY WIRE
BTIC	BRITISH TELECOM CHAMBER	MkrE	MARKER POST (ELECTRIC)	SV	STOP VALVE
CaTL	CATENARY LEVEL	MkrG	MARKER POST (GAS)	SVP	SOIL VENT PIPE
CATV	CABLE TV COVER	MkrR	MARKER POST (RAILWAY)	TBM	TEMPORARY BENCH MARK
CB	CONTROL BOX	MkrT	MARKER POST (TELECOM)	TCB	TELEPHONE CALL BOX
CBt	CONVEYOR BELT	MkrW	MARKER POST (WATER)	TEL	TELECOM CHAMBER COVER
CC	COAL CHUTE	MP	MILE POST	TFR	TAKEN FROM RECORDS
CGrd	CATTLE GRID	MS	MILE STONE	Thl	THRESHOLD LEVEL
ChL	CHANNEL LEVEL	NL	NOT LOCATED	TL	TRAFFIC LIGHT
Chy	CHIMNEY	NP	NAME PLATE	TP	TELEGRAPH POLE
CI	CAST IRON	OSA	OUTSIDE SURVEY AREA	Tpt	TRIAL PIT
CL	COVER LEVEL	OSBM	O.S BENCH MARK	Tr	TROUGH
CO	CONCRETE	OGP	OVERGROUND PIPE	UTF	UNABLE TO FIND
CP	CABLE PIT	OHCu	O/H CABLE (UNIDENTIFIED	UTGA	UNABLE TO GAIN ACCESS
CpL	COPING LEVEL	OHE	OVERHEAD CABLE (ELECTRIC	UTL	UNABLE TO LIFT
Cpsn	CAPSTAN	OHG	OVERHEAD GANTRY	UTR	UNABLE TO ROD
Cpst	CAMERA POST	OHP	OVERHEAD PIPE	UTS	UNABLE TO SURVEY
CR	CABLE RISER	OHT	OVERHEAD CABLE (TELECOM	UUT	UNABLE TO TRACE
CrL	CROWN LEVEL	OP	OUTLET PIPE	VC	VITREOUS CLAY
CuP	CULVERT PIPE	P	POST	VP	VENT PIPE
CWM	CABLE WINDING MACHINERY	Pb	PARK BENCH	VR	VAPOUR RECOVERY
d	DEPTH	PB	POST BOX	VS	VENTILATION SHAFT
Dia.	DIAMETER	PCsg	PEDESTRIAN CROSSING	VV	VALVE / SLUICE WHEEL
DS	DIRECTION SIGN	PE	POLYETHALINE	WB	WEIGHBRIDGE
EIC	ELECTRIC INSPECTION COVER	PF	PITCH FIBER	WL	WATER LEVEL
EoC	EDGE OF CANOPY	Pl	PILE	WM	WATER METER
EOR	END OF RECORDS	Plr	MOVEMENT DETECTOR	WO	WASH OUT VALVE
EOT	END OF TRACE	Pmd	PLANT MOTOR DRIVE	Wr	WEIR
EP	ELECTRICITY POLE	PP	PETROL / DIESEL PUMP	WrL	WEIR LEVEL
ER	EARTH ROD	PR	PIPE RISER	WrPl	WEIR PLATE (TOP)
EShwr	EMERGENCY SHOWER	Psk	PENSTOCK	WWP	WASTE WATER PIPE
ESP	ELECTRICITY SUPPLY POINT	PU	PUMP		
Esw	ELECTRICAL SWITCH	PV	PIPE (VERTICAL)		
FB	FOOTBRIDGE	PVC	POLYVINYL CHLORIDE		
FH	FIRE HYDRANT	Pyl	PYLON		
FL	FLOOR LEVEL	Pz	PIEZOMETER		
FS	FLAG STAFF / POLE	RE	RODDING EYE		
G	GULLY	RG	RAIN GAUGE		
G=	GIRTH	RMP	RESERVOIR MONITORING PNT		
GIP	GAS INLET PIPE	RP	REFLECTOR POST		
GP	GUIDE POST	RS	ROAD SIGN		
GPR	TRACED BY G.P.R	RSP	RAILWAY SIGNAL POST		
Grl	GRILLE	RWP	RAIN WATER PIPE		
GV	GAS VALVE	S	SPREAD		
Hgt	HEIGHT	SA	SURVEY ABANDONED		
Hrl	HANDRAIL	SB	SIGN BOARD		
HV	HIGH VOLTAGE	Sht	SHELTER (BUS / TRAM)		
IC	INSPECTION CHAMBER	SI	SPUN IRON		
IL	INVERT LEVEL	SL	SOFFIT LEVEL		
IP	INLET PIPE	StL	SILT LEVEL (TOP)		
JN	JUNCTION	SMP	SETTLEMENT MONITORING PNT		

KEY

TV	CCTV / CABLE TELEVISION
450	COMBINED DRAINAGE
COM	COMMUNICATIONS CABLE
A	COMPRESSED AIR
	DUCTING
E	EARTH CABLE
	ELECTRIC CABLE
EOT	END OF TRACE
150	FOUL DRAINAGE
F	FUEL PIPE
	GAS PIPE
G	GAUGE LINE
H	HEATING
O	OFFSET FILL PIPE
	PUMPING MAIN
	RADAR AREA ANOMALY
R	RADAR UTILITY TRACE
300	SURFACE DRAINAGE
	SURVEY BOUNDARY
T	TELECOM CABLE
TL	TRAFFIC LIGHTS
U	UNIDENTIFIED
VR	VAPOUR RECOVERY
V	VENT PIPE
	WATER PIPE

North:

Grid: By Others

Levelling: By Others

Drawing Title:
Underground Utility Survey

Site Address:
Egley Road
Woking

Client:
Cala Homes

Surveyor	AP	Drawn By	CP	Verified By	SC	Date	27.03.23
CM No: CMU/23204				Rev:			
Scale: 1:200m @ A0				Date: April 2023			

Cadmap
Cadmap Ltd
Unit 131 Dunsfold Park
Cranleigh
Surrey, GU6 8TB
T: 01483 429385
E: info@cadmap.co.uk
W: www.cadmap.co.uk

SSIP worksafe consultant www.smasltd.com
CHAS Accredited Contractor www.chas.gov.uk
THE SURVEY ASSOCIATION
Constructionline